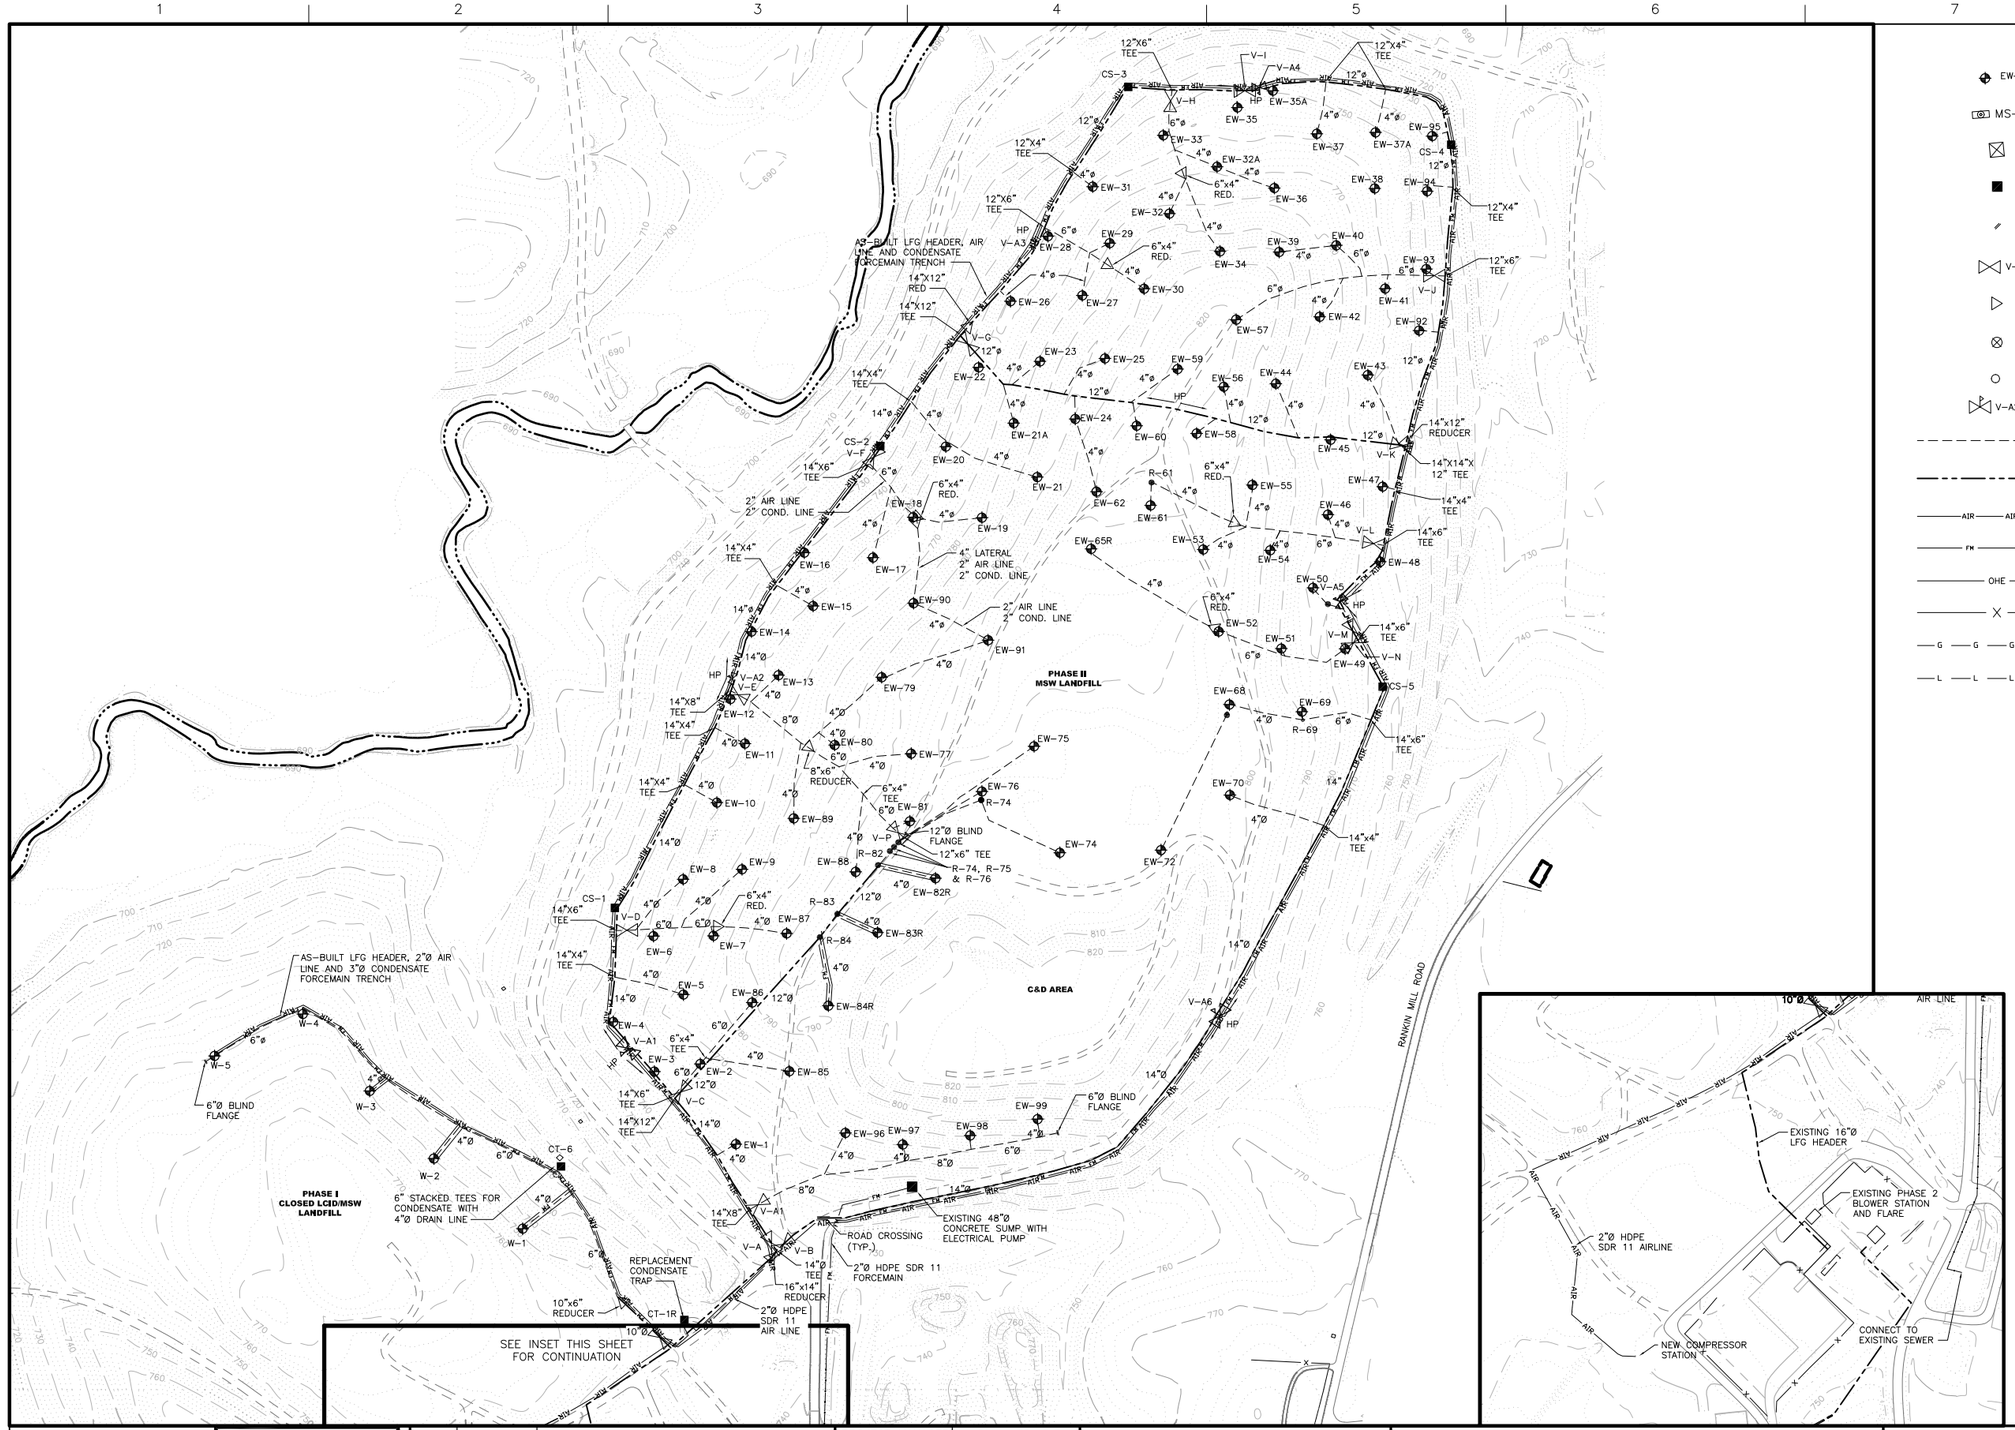

LEGEND

EW-12	EXISTING VERTICAL EXTRACTION WELL
MS-4	EXISTING MONITORING STATION
	EXISTING OVERHEAD ELECTRIC POLES
	EXISTING CONDENSATE TRAP
	EXISTING BLIND FLANGE (SIZE VARIES)
V-E	EXISTING GATE VALVE (SIZE VARIES)
	EXISTING HDPE REDUCER (SIZE VARIES)
	EXISTING REMOTE WELLHEAD (SIZE VARIES)
	EXISTING LEACHATE CLEANOUT
V-A2	EXISTING ASBUILT AIR RELEASE VALVE
	EXISTING HDPE SDR 11 LATERAL (SIZE VARIES)
	EXISTING HDPE SDR 17 HEADER PIPE (SIZE VARIES)
AIR	EXISTING 2"Ø HDPE SDR 11 AIRLINE
FM	EXISTING ASBUILT LANDFILL GAS CONDENSATE FORCEMAIN
OHE	EXISTING OVERHEAD ELECTRIC LINE
X	EXISTING FENCE LINE
G	EXISTING GAS PIPE
L	EXISTING LEACHATE COLLECTION SYSTEM

NOTES:
1. TOPOGRAPHY OBTAINED FROM HDR ENGINEERING, INC. OF THE CAROLINAS, INC (CHARLOTTE, N.C. OFFICE) DATED 2007.
2. EXISTING GAS COLLECTION AND CONTROL SYSTEM DATA OBTAINED FROM WHITE STREET LANDFILL, PHASE III PARTIAL CLOSURE DRAWINGS BY HDR ENGINEERING, INC. OF THE CAROLINAS, INC (CHARLOTTE, N.C. OFFICE) DATED APRIL 2009.
3. WELL LOCATIONS FOR PHASES I & II ARE FROM A SURVEY CONDUCTED BY THE CITY OF GREENSBORO, NC. SURVEY CONDUCTED IN JULY 2006.

N

SCALE IN FEET
200 100 0 200 400

HDR
HDR Engineering, Inc. of the Carolinas
128 S Tryon Street, Suite 1400 | Charlotte, NC 28202

ISSUE	DATE	DESCRIPTION
A	07/09	ASBUILT RECORD DRAWINGS

PROJECT MANAGER	M. PLUMMER, P.E.
DESIGNED BY	L. DAIGLE, E.I.T.
DESIGNED BY	
DRAWN BY	D. SOSA
DRAWN BY	
CHECKED BY	C. LEBRON, P.E.
PROJECT NUMBER	110048

WHITE STREET LANDFILL RECORD DRAWINGS PHASES I, II & III

Greensboro North Carolina

ASBUILT RECORD DRAWING PHASES I & II

0 1" 2"
AT FULL SIZE BAR LENGTH EQUALS TWO INCHES. ADJUST SCALE ACCORDINGLY

FILENAME	00C-01.dwg
SCALE	1"=200' (FULL SIZE)

SHEET 00C-01

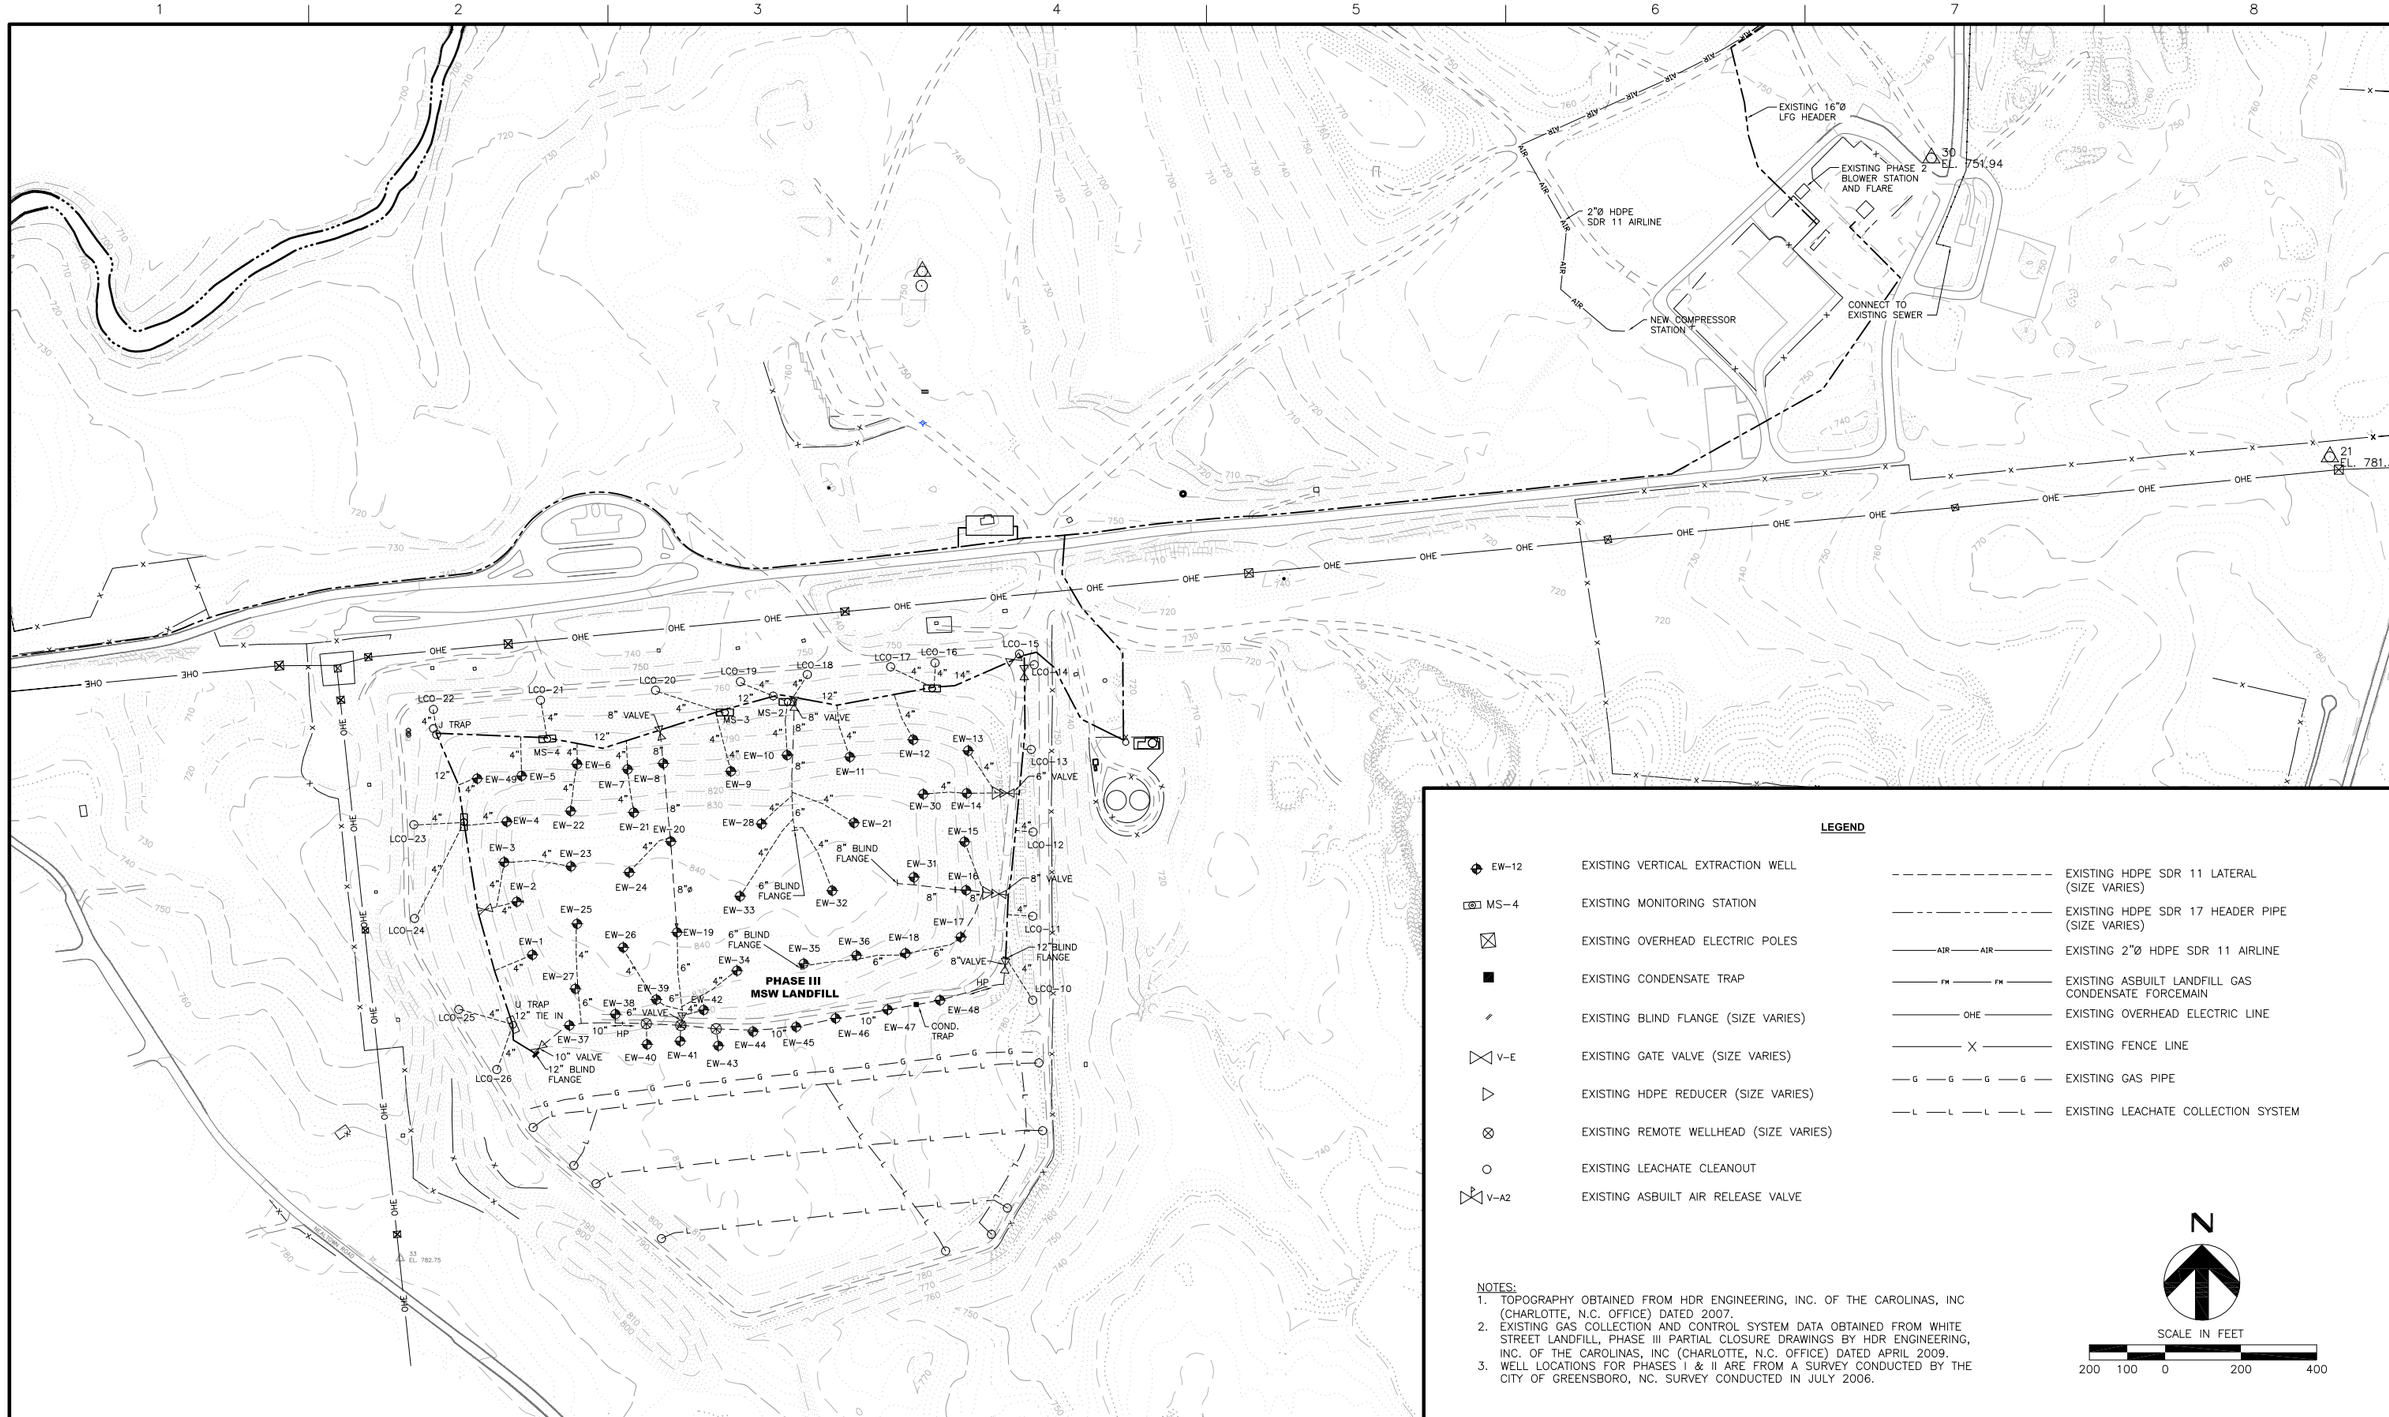

LEGEND

EW-12	EXISTING VERTICAL EXTRACTION WELL		EXISTING HDPE SDR 11 LATERAL (SIZE VARIES)
MS-4	EXISTING MONITORING STATION		EXISTING HDPE SDR 17 HEADER PIPE (SIZE VARIES)
	EXISTING OVERHEAD ELECTRIC POLES	AIR	EXISTING 2"Ø HDPE SDR 11 AIRLINE
	EXISTING CONDENSATE TRAP	FM	EXISTING ASBUILT LANDFILL GAS CONDENSATE FORCEMAIN
	EXISTING BLIND FLANGE (SIZE VARIES)	OHE	EXISTING OVERHEAD ELECTRIC LINE
V-E	EXISTING GATE VALVE (SIZE VARIES)	X	EXISTING FENCE LINE
	EXISTING HDPE REDUCER (SIZE VARIES)	G	EXISTING GAS PIPE
	EXISTING REMOTE WELLHEAD (SIZE VARIES)	L	EXISTING LEACHATE COLLECTION SYSTEM
	EXISTING LEACHATE CLEANOUT		
V-A2	EXISTING ASBUILT AIR RELEASE VALVE		

NOTES:
1. TOPOGRAPHY OBTAINED FROM HDR ENGINEERING, INC. OF THE CAROLINAS, INC (CHARLOTTE, N.C. OFFICE) DATED 2007.
2. EXISTING GAS COLLECTION AND CONTROL SYSTEM DATA OBTAINED FROM WHITE STREET LANDFILL, PHASE III PARTIAL CLOSURE DRAWINGS BY HDR ENGINEERING, INC. OF THE CAROLINAS, INC (CHARLOTTE, N.C. OFFICE) DATED APRIL 2009.
3. WELL LOCATIONS FOR PHASES I & II ARE FROM A SURVEY CONDUCTED BY THE CITY OF GREENSBORO, NC. SURVEY CONDUCTED IN JULY 2006.

N

SCALE IN FEET
200 100 0 200 400

HDR
HDR Engineering, Inc. of the Carolinas
128 S Tryon Street, Suite 1400 | Charlotte, NC 28202

ISSUE	DATE	DESCRIPTION
A	07/09	ASBUILT RECORD DRAWINGS

PROJECT MANAGER	M. PLUMMER, P.E.
DESIGNED BY	L. DAIGLE, E.I.T.
DESIGNED BY	
DRAWN BY	D. SOSA
DRAWN BY	
CHECKED BY	C. LEBRON, P.E.
PROJECT NUMBER	110048

WHITE STREET LANDFILL RECORD DRAWINGS PHASES I, II & III

Greensboro North Carolina

ASBUILT RECORD DRAWING PHASE III

0 1" 2"
AT FULL SIZE BAR LENGTH EQUALS TWO INCHES. ADJUST SCALE ACCORDINGLY

FILENAME	00C-02.dwg
SCALE	1"=200' (FULL SIZE)

SHEET 00C-02